


R. Apple D
15 19 24 No. 111

No. 177.

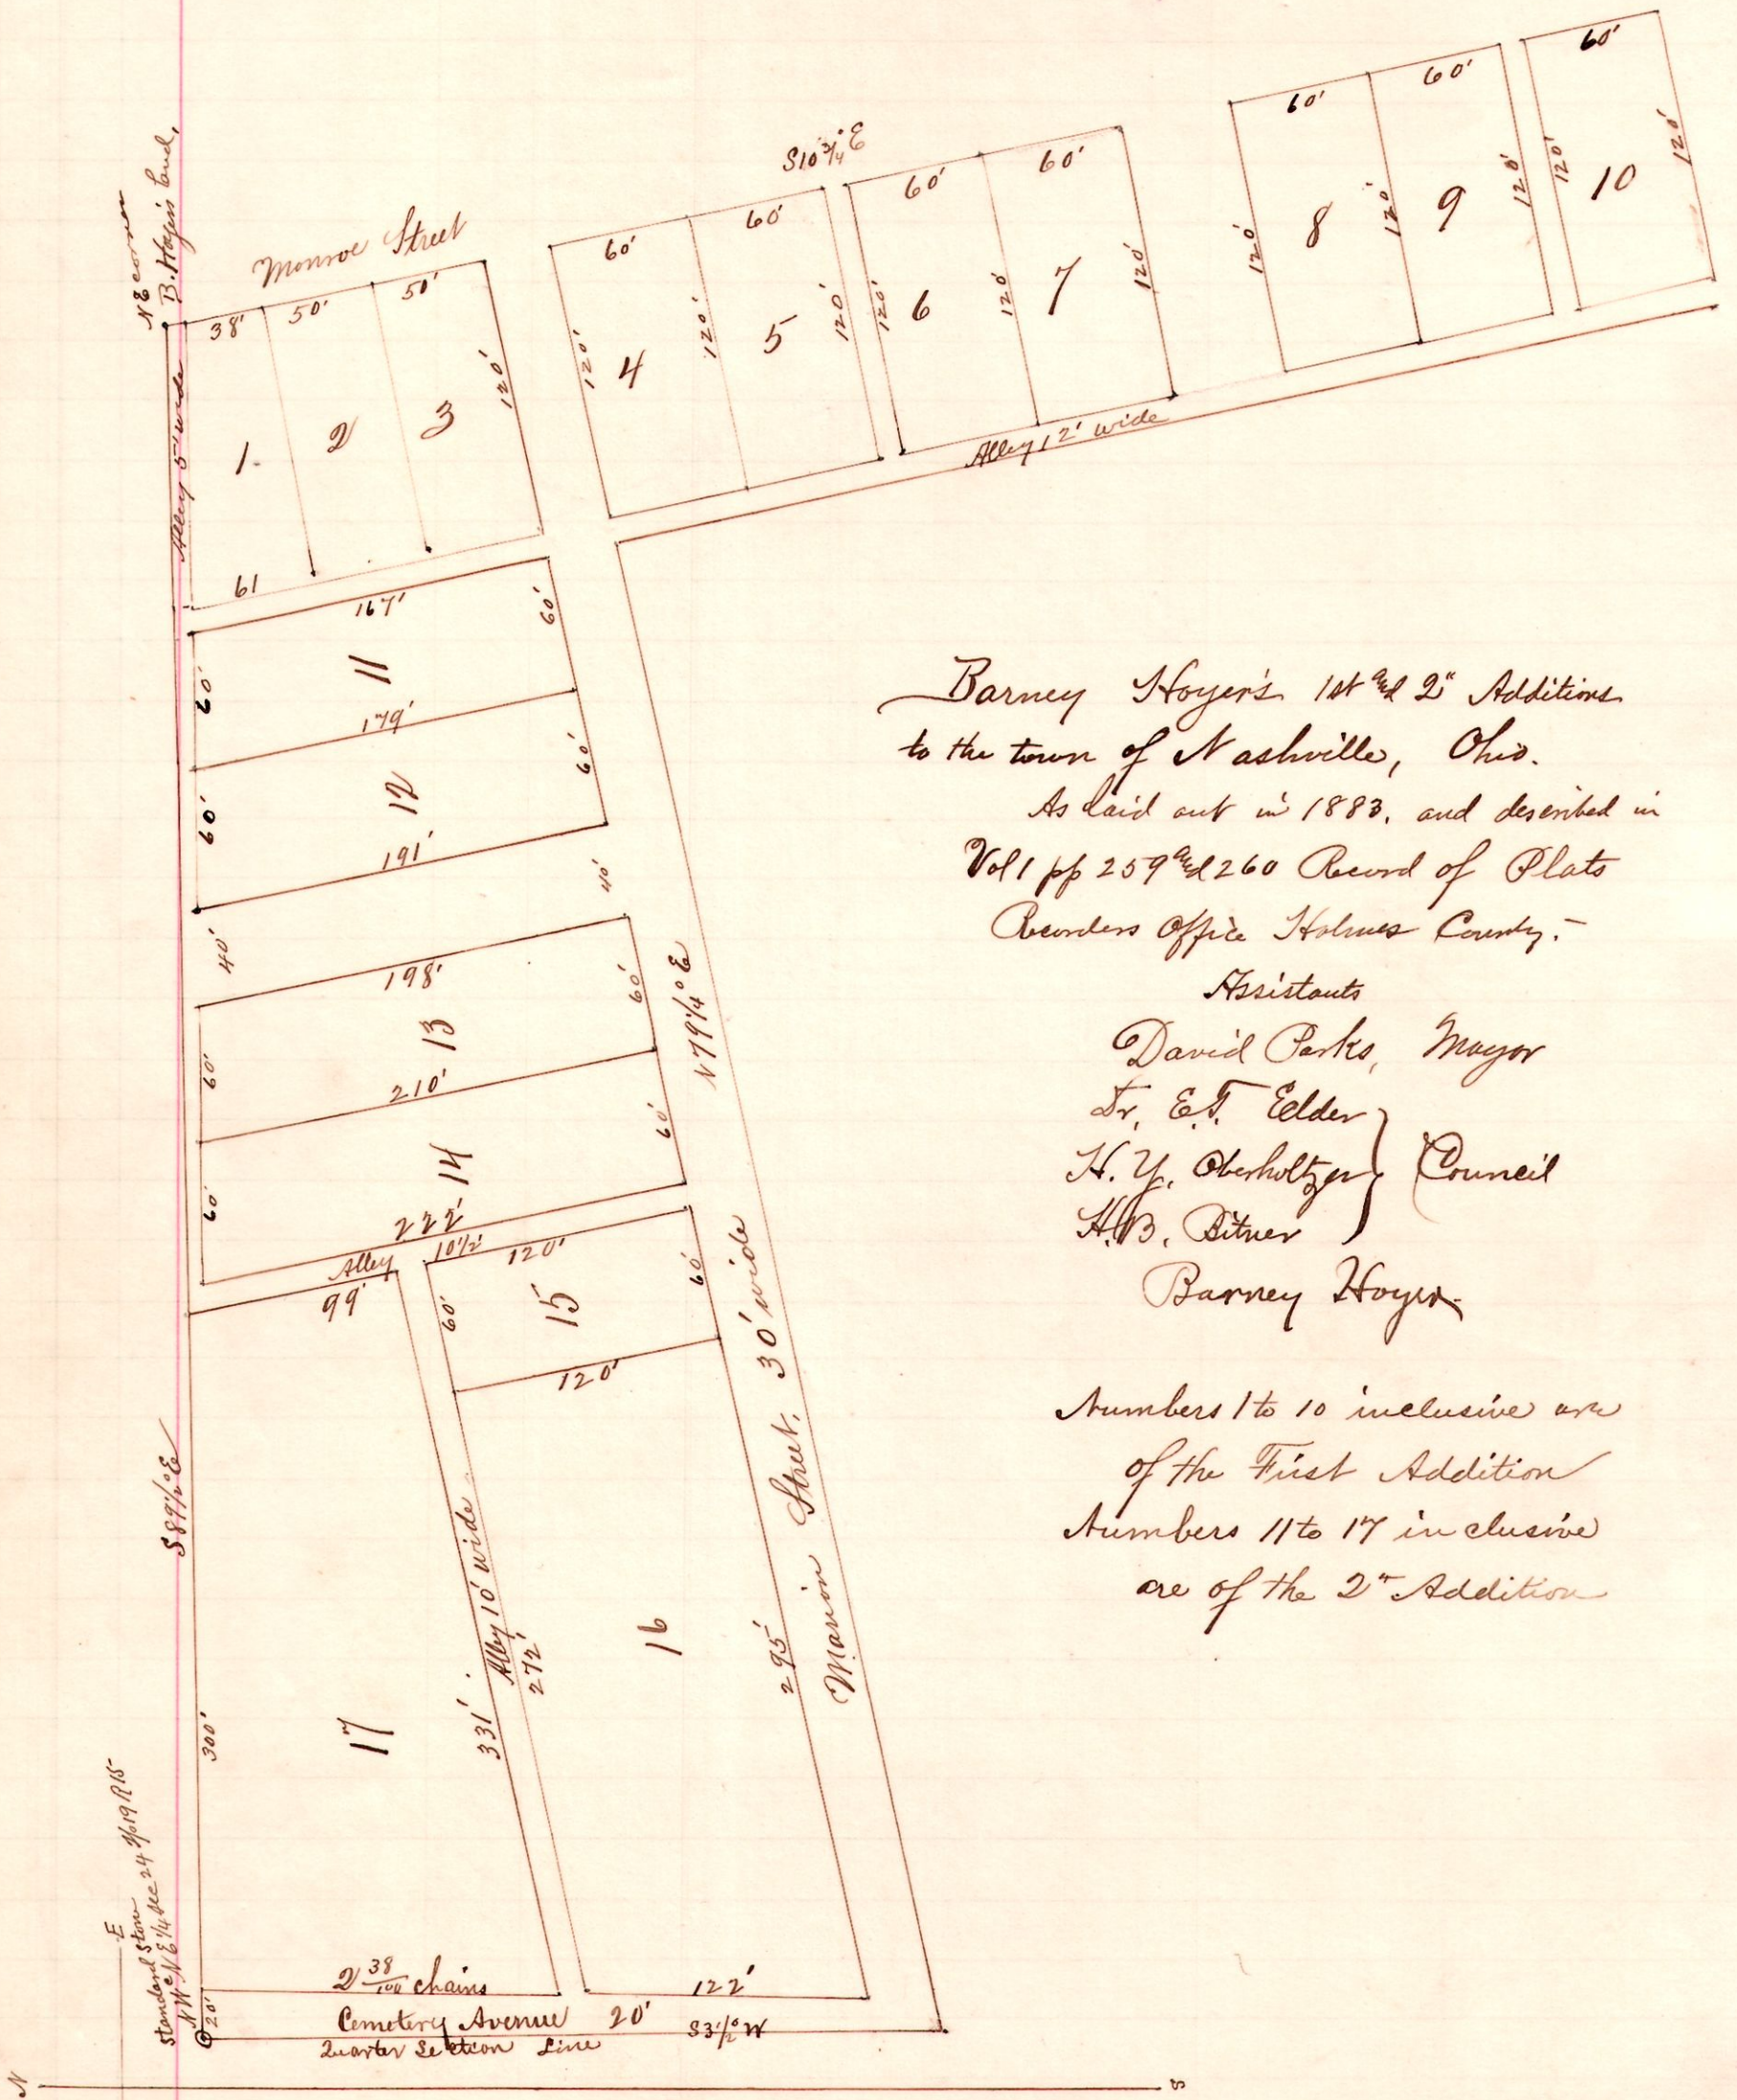

Barney Hoyer's 1st and 2d Additions
to the town of Nashville, Ohio.

As laid out in 1883, and described in
Vol 1 pp 259 and 260 Record of Plato
Recorder Office Holmes County.

Assistants
 David Parks, Mayor
 Dr. E. T. Elder
 H. Y. Oberholzer } Council
 A. B. Bitner
 Barney Hoyer.

Numbers 1 to 10 inclusive are
of the First Addition
 Numbers 11 to 17 inclusive
are of the 2^d Addition

A Resurvey of Barney Hoyer's 1st and 2^d Additions to the town of
Nashville, as an addition to the Corporation by the Council -
Oct. 7th, 1896.

Frank H. Gunt,
 Surveyor,
 Holmes Co.,
 Ohio.