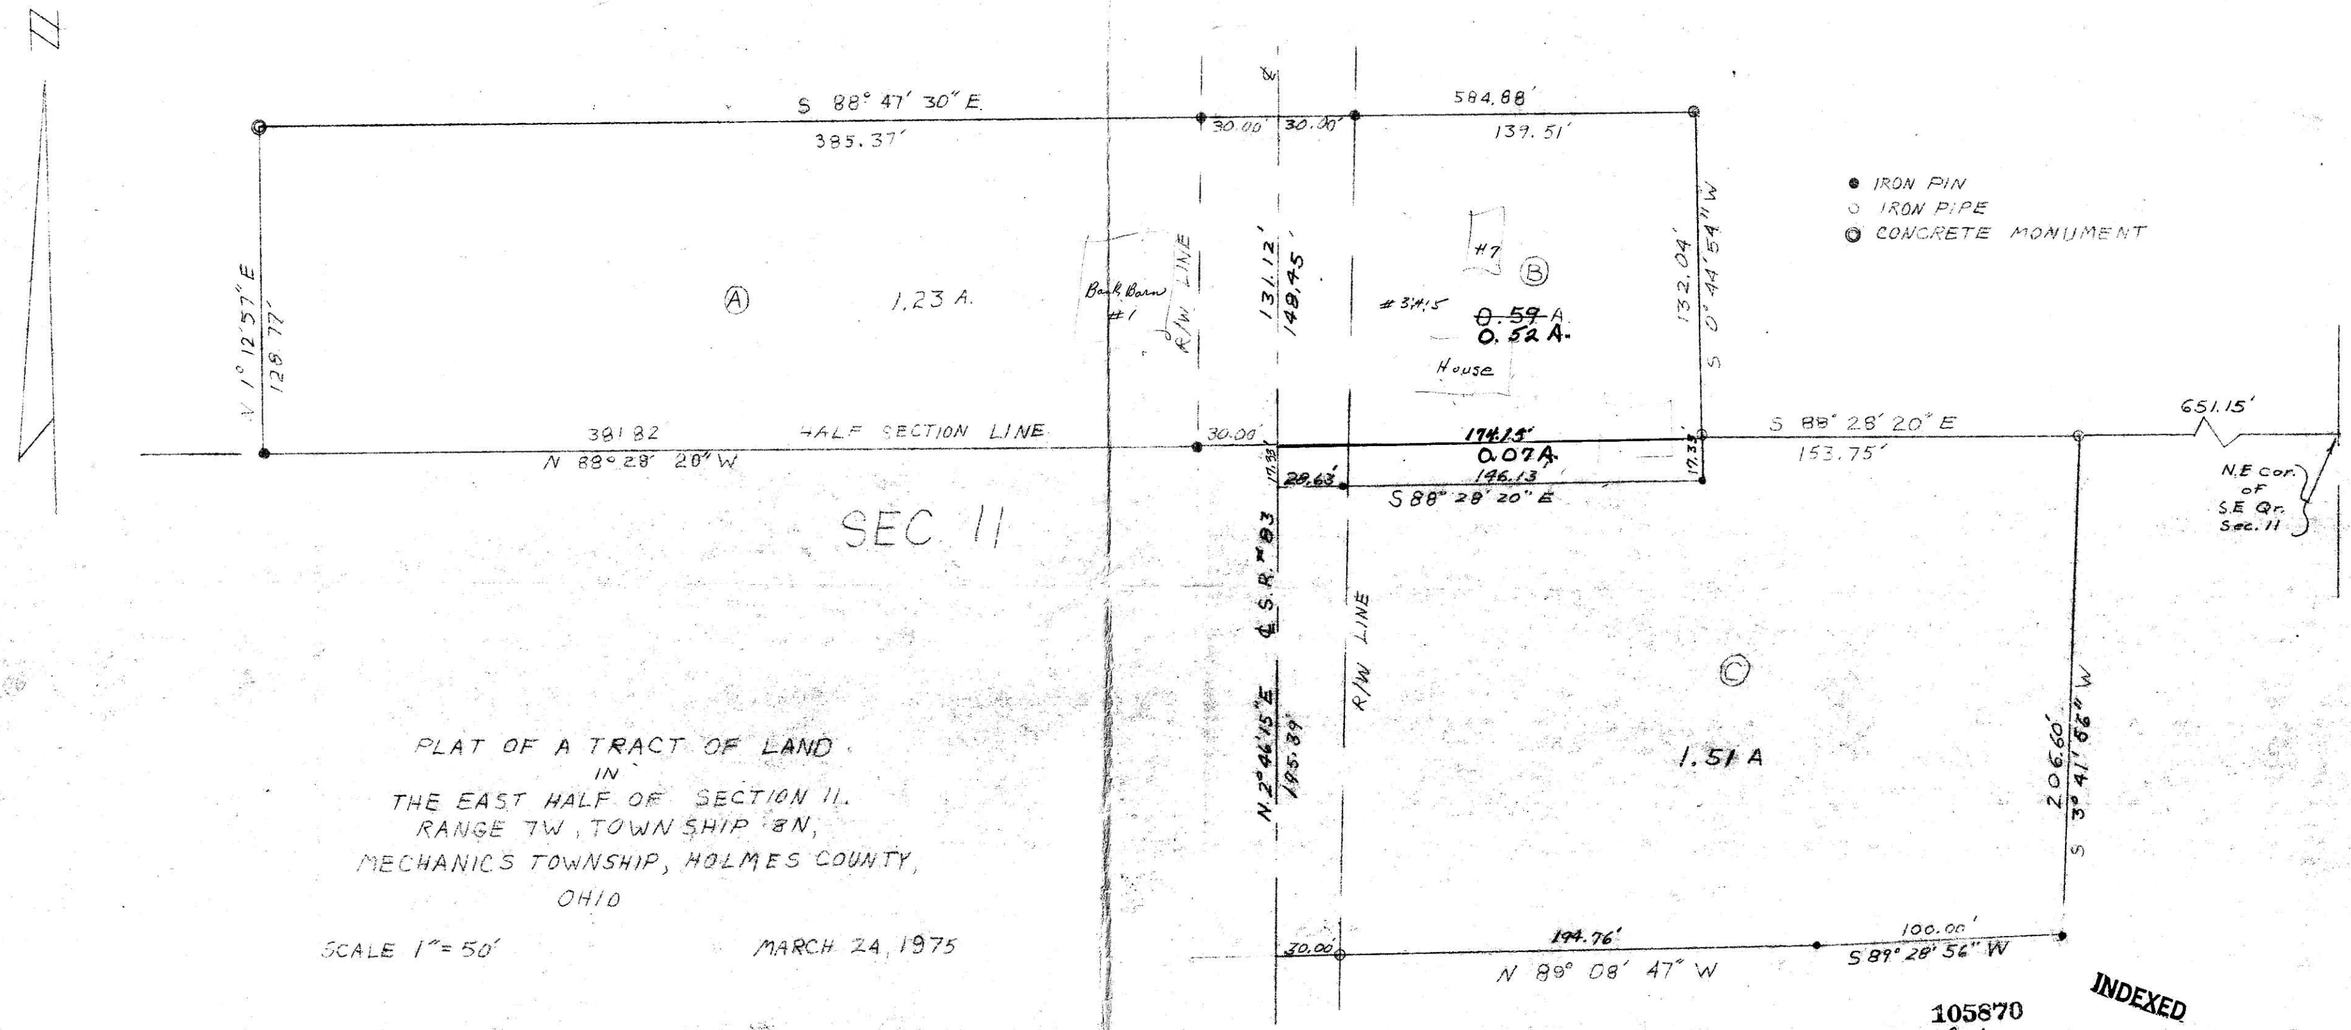

PLAT OF A TRACT OF LAND
IN
THE EAST HALF OF SECTION 11.
RANGE 7W, TOWNSHIP 8N,
MECHANICS TOWNSHIP, HOLMES COUNTY,
OHIO

SCALE 1" = 50'

MARCH 24, 1975

D. J. Stewart, R.S. 7414

PARCEL A	1.23 Acres	
~~PARCEL B~~	~~0.59 Acres~~	
PARCEL C	1.51 Acres	
TOTAL	3.33 Acres	

INDEXED

105870
RECD: Oct. 10, 1975
AT 2:19 O'CLOCK p.m.
RECORDED: Oct. 14 1975
HOLMES CO/ Plat VOL. 6 PG. 76
FEE: $ 5.46
Richard Graves RECORDER
21 X 13 X 2
Deed Vol. 192-Pgs. 102, 106, 110

MAP OFFICE COPY